


Date: Thursday, 26/06/2008 12:51:11 PM  
User: Jean-Luc Menard

## Process Sheet

Customer	: CU-DAR001 Dart Helicopters Services	Drawing Name	: BRACKET ASSEMBLY
Job Number	: 39924		
Estimate Number	: 10281		
P.O. Number	:	Part Number	: D3183043
This Issue	: 26/06/2008 S.O. No. :	Drawing Number	: D3183 REV C1
Prsht Rev.	: NC	Project Number	: N/A
First Issue	: 26/06/2008 Type : MACHINED PARTS	Drawing Revision	: C1
Previous Run	: 39862	Material	:
Written By	: <u>SL 06.06.26.</u>	Due Date	: 03/07/2008 Qty: 10 Um: Each
Checked & Approved By	:		
Comment	: Est Rev: Pick: A 04.02.18 New issue KJ/DS Est Rev: B Changed Mat Size 08-06-26 JLM Verified By: EC		

## Additional Product

Job Number:

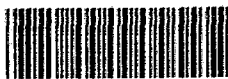

Seq. #:	Machine Or Operation:	Description :
---------	-----------------------	---------------

1.0	M174B1500X02250	17-4 SS Bar 1.5"x2.250"
-----	-----------------	-------------------------



Comment: Qty.: 0.4812 f(s)/Unit Total : 4.8122 f(s)  
Material: 17-4 SS Bar per AMS 5604/5643  
(M17-4-B1.500x02.25)  
Identify for D3183-043  
Batch: M108309

SL 08/07/08 (16)

2.0	BAND SAW	BAND SAW
-----	----------	----------



Comment: BAND SAW  
Cut blanks: (1.500" x 2.000") 5.500" long

SL 08/07/08

3.0	HAAS1	HAAS CNC VERTICAL MACHINING #1
-----	-------	--------------------------------



Comment: HAAS CNC VERTICAL MACHINING #1

1-Machine D3183-3 as per Folio FA322 and Dwg D3183  
Identify as D3183-3

2-Deburr

3-Scribe batch number

SL 08/07/08 (6x)

SL 08/07/08

SL 08/07/08

4.0	QC2	INSPECT PARTS AS THEY COME OFF MACHINE
-----	-----	--



Comment: INSPECT PARTS AS THEY COME OFF MACHINE

SL 08/07/08

# Dart Aerospace Ltd

W/O:		WORK ORDER CHANGES					
DATE	STEP	PROCEDURE CHANGE	By	Date	Qty	Approval Chief Eng / Prod Mgr	Approval QC Inspector

Part No: D3183-043 PAR #:            Fault Category: Machining NCR: Yes No DQA: AS Date: 08/02/17  
D412-698-011/031 QA: N/C Closed: AS Date: 08/08/17

NCR: <u>39924</u>		WORK ORDER NON-CONFORMANCE (NCR)						
DATE	STEP	Description of NC Section A	Corrective Action Section B			Verification Section C	Approval Chief Eng	Approval QC Inspector
			Initial Chief Eng	Action Description Chief Eng	Sign & Date			
8/7/10	3-D	From second check of parts from machine operation he noticed that 6 parts had Dim. 0.162" ranging from 0.150" to 0.148".	CP 08-07-17 PV AS/07/17	hold all 6 parts in till notification From David Shephard. PARTS ACCEPTABLE. REX DS EMAIL Last page	DS 08/07/17	S 08/07/17	CP 08-07-17 PV 08/04/17	S 08/07/17
		RC operator on other shift had He too tool heights Differating from what was on the mill.						

NOTE: Date & initial all entries

## Process Sheet

Customer: CU-DAR001 Dart Helicopters Services

Drawing Name: BRACKET ASSEMBLY

Job Number: 39924

Part Number: D3183043

Job Number:



Seq. #: Machine Or Operation:

Description :

5.0 QC8

SECOND CHECK



Comment: SECOND CHECK

J.L 08/07/18

6.0 D312121

Bolt



Comment: Qty.: 2.0000 Each(s)/Unit Total : 20.0000 Each(s)

Pick:

Qty Part Number  
2 D3121-21

Description Batch  
Bolt B 39947

(6X)

B46284 (4X)

08/08/20

7.0 D3183045

Bearing Assembly



Comment: Qty.: 2.0000 Each(s)/Unit Total : 20.0000 Each(s)

Pick:

Qty Part Number  
2 D3183-045 Bearing Ass

Description Batch  
B40496

(10X)

B40159 (4X)

08/08/20

8.0 SMALL FAB 1

SMALL & MEDIUM FAB RESOURCE 1



Comment: SMALL & MEDIUM FAB RESOURCE 1  
Assemble D3183-043 as per Dwg D3183.

08/08/20 (10)

9.0 QC5

INSPECT WORK TO CURRENT STEP



Comment: INSPECT WORK TO CURRENT STEP

08/08/20 (10)

10.0 PACKAGING 1

PACKAGING RESOURCE #1



Comment: PACKAGING RESOURCE #1

Identify and Stock

Location: 233A

8/8/20

(10X)

11.0 QC21

FINAL INSPECTION/W/O RELEASE



Comment: FINAL INSPECTION/W/O RELEASE

08/08/20

Job Completion



MF 08-08-20

<b>DART AEROSPACE LTD</b>		<b>Work Order:</b> 39924
<b>Description:</b> Bracket		<b>Part Number:</b> D3183 3
<b>Inspection Dwg:</b> D3183	<b>Rev:</b> C1	<b>Page 1 of 1</b>

### FIRST ARTICLE INSPECTION CHECKLIST

☒ First Article ☐ Prototype

Drawing Dimension	Tolerance	Actual Dimension	Accept	Reject	Method of Inspection	Comments
R0.190	+/-0.030	.190	✓			
R0.063	+/-0.010	.063	✓			
<del>0.188</del> N/A	+/-0.010		✓			
0.070	+/-0.010	.073	✓			
0.100	+/-0.010	.102	✓			
Ø0.201 x 0.100	+/-0.010	.203 x .09	✓			
<del>0.183</del> 0.182	+/-0.010	.182	✓			
5.32	+/-0.030	5.308	✓			
5.036	+/-0.010	5.032	✓			
2.120	+/-0.010	2.122	✓			
1.290	+/-0.010	1.292	✓			
0.365	+/-0.010	.36	✓			
0.218	+/-0.010	.212	✓			
1.030	+/-0.010	1.029	✓			
1.90	+/-0.030	1.896 / .890	✓			
1.012	+/-0.010	1.006	✓			
Ø0.201 x 0.100	+/-0.010	.203 x .09	✓			
0.786	+/-0.010	.778	✓			
Ø0.392	+0.002/-0.000	.392	✓			
R0.19	+/-0.030	.187	✓			
3.954	+/-0.010	3.956	✓			
0.162	+/-0.010	.160	✓			
R0.19	+/-0.030	.187	✓			
R0.25	+/-0.030	.250	✓			
4.26	+/-0.030	4.266	✓			
2.800	+/-0.030	2.800	✓			
Calculated dimension						
0.162	+/-0.010	.160	✓			
0.615	+/-0.010	.615	✓			
0.435	+/-0.010	.435	✓			
0.200	+/-0.010	.203	✓			
0.381	+/-0.010	.382	✓			
0.032	+/-0.010	.030	✓			


<b>Measured by:</b> JS	<b>Audited by:</b> JL	<b>Prototype Approval:</b>	N/A
<b>Date:</b> 08/07/08	<b>Date:</b> 08/07/08	<b>Date:</b>	N/A

Rev	Date	Change	Revised by	Approved
A	03.11.12	New Issue P/O D3183-044	KJ/RF	
B	04.03.15	Changes as per revision C	KJ/JLM/RF	
C	04.06.15	Dimension 2.800 was 2.080; removed 1.155, 0.36 dimensions	KJ/JLM	
D	06.03.09	Dwg Rev update	KJ/JLM	
E	08.01.16	Dimensions revised	KJ/EC/DD	




DESIGN <i>#</i>	DRAWN BY <i>UP</i>	<b>DART AEROSPACE LTD</b> HAWKESBURY, ONTARIO, CANADA	
CHECKED <i>#</i>	APPROVED <i>#</i>	DRAWING NO. <b>D3183</b>	REV. C SHEET 1 OF 4
DATE <b>04.02.17</b>		TITLE <b>BRACKET ASSEMBLY</b>	SCALE 1:1
A.	03.01.24	NEW ISSUE	
B	03.06.17	REMOVE BEARING; 1.012 WS 0.882	
C	04.02.17	ADD -045/-9; 0.182 WAS 0.431	
C1	<del>#</del> 04.11.09	0.830 WAS 0.850	

RELEASED  
04.03.01 *#*

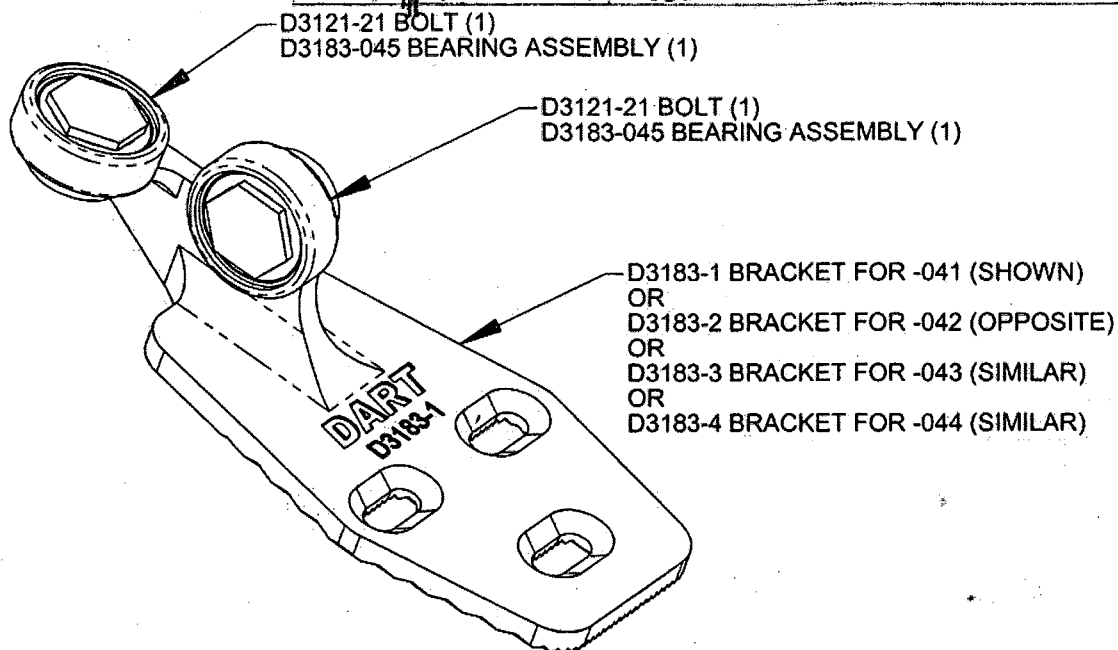

**D3183-041 BRACKET ASSEMBLY (SHOWN)**  
**D3183-042 BRACKET ASSEMBLY (OPPOSITE)**  
**D3183-043 BRACKET ASSEMBLY (SIMILAR)**  
**D3183-044 BRACKET ASSEMBLY (SIMILAR)**

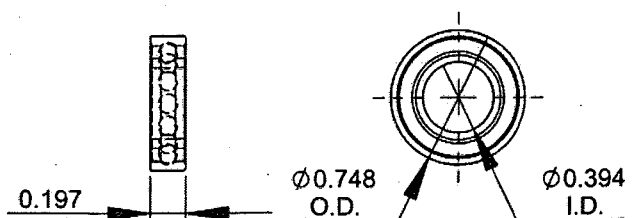


**D3183-5 BEARING:**  
**SPECIFICATION CONTROL DRAWING**

- 1) SINGLE ROW, DEEP GROOVE, CONRAD TYPE, SHIELDED
- 2) POSSIBLE SUPPLIER: NSK P/N 68002Z
- 3) ALL DIMENSIONS ARE IN INCHES

SHOP COPY

27 RETURN TO  
ENGINEERING  
UNCONTROLLED COPY  
SUBJECT TO AMENDMENT  
WITHOUT NOTICE  
WORK ORDER  
NO. 399241

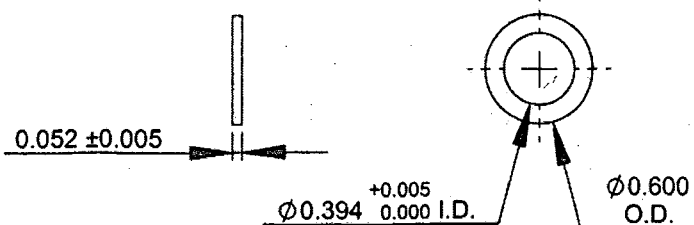

**D3183-7 WASHER**

- 1) MATERIAL: AISI 303 ROUND BAR (M303R)  
ANNEALED
- 2) BREAK ALL SHARP EDGES 0.005 TO 0.010
- 3) TOLERANCES ARE PER DART QSI 018  
UNLESS OTHERWISE NOTED
- 4) ALL DIMENSIONS ARE IN INCHES

COPYRIGHT © 2003 BY DART AEROSPACE LTD.





THIS DOCUMENT IS PRIVATE AND CONFIDENTIAL AND IS SUPPLIED ON THE EXPRESS CONDITION THAT IT IS NOT TO BE USED FOR ANY PURPOSE OR COPIED OR COMMUNICATED TO ANY OTHER PERSON WITHOUT WRITTEN PERMISSION FROM DART AEROSPACE LTD.

**DART**

QA COPIES  
ISSUED

DESIGN	DRAWN BY	DART AEROSPACE LTD
CHECKED <i>[Signature]</i>	APPROVED <i>[Signature]</i>	HAWKESBURY, ONTARIO, CANADA
DATE 04.02.17	DRAWING NO. D3183	REV. C
	TITLE BRACKET ASSEMBLY	SHEET 2 OF 4
		SCALE 1:2

RELEASED  
04.03.01

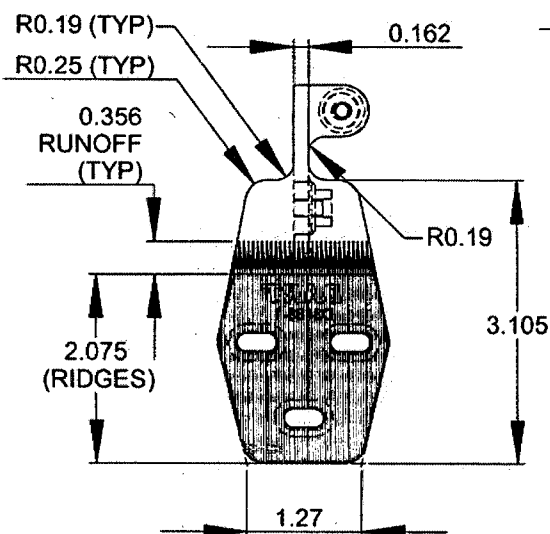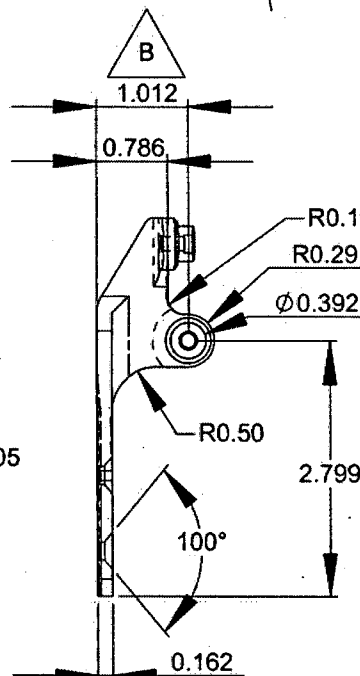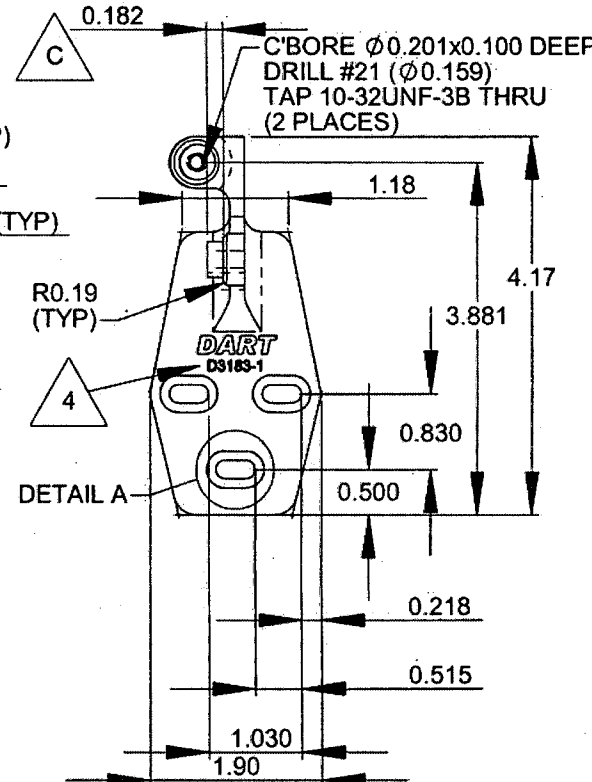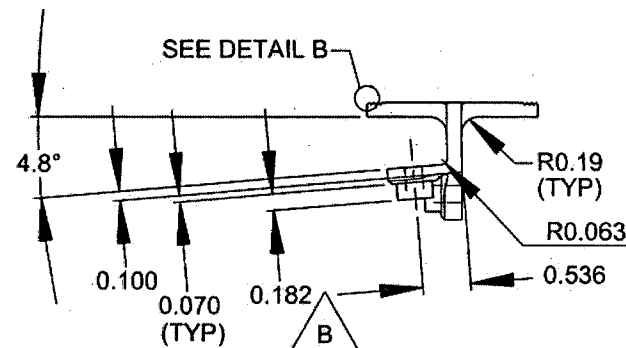

**D3183-1 BRACKET SHOWN  
D3183-2 BRACKET OPPOSITE**

- 1) D3183-1 CAN BE MADE FROM D3183-3  
D3183-2 CAN BE MADE FROM D3183-4
- 2) MATERIAL: 17-4 SS PER AMS 5604/5643  
(REF DART SPEC. M17-4-B)  
MIN ULTIMATE STRENGTH = 150  
MIN YIELD STRENGTH = 100 ksi
- 3) BREAK ALL SHARP EDGES 0.005 TO 0.015
- 4) ENGRAVE DART P/N & LOGO AS SHOWN
- 5) TOLERANCES ARE PER DART QSI 018 UNLESS OTHERWISE NOTED
- 6) ALL DIMENSIONS ARE IN INCHES


SHOP COPY  
RETURN TO  
ENGINEERING  
UNCONTROLLED COPY  
SUBJECT TO AMENDMENT  
WITHOUT NOTICE  
WORK ORDER  
NO. 34724

COPYRIGHT © 2003 BY DART AEROSPACE LTD.

THIS DOCUMENT IS PRIVATE AND CONFIDENTIAL AND IS SUPPLIED ON THE EXPRESS CONDITION THAT IT IS NOT TO BE USED FOR ANY PURPOSE OR COPIED OR COMMUNICATED TO ANY OTHER PERSON WITHOUT WRITTEN PERMISSION FROM DART AEROSPACE LTD.



DESIGN	DRAWN BY	DART AEROSPACE LTD
CHECKED	APPROVED	HAWKESBURY, ONTARIO, CANADA
DATE 04.02.17	DRAWING NO. D3183	REV. C
	TITLE BRACKET ASSEMBLY	SHEET 3 OF 4
		SCALE 1:2

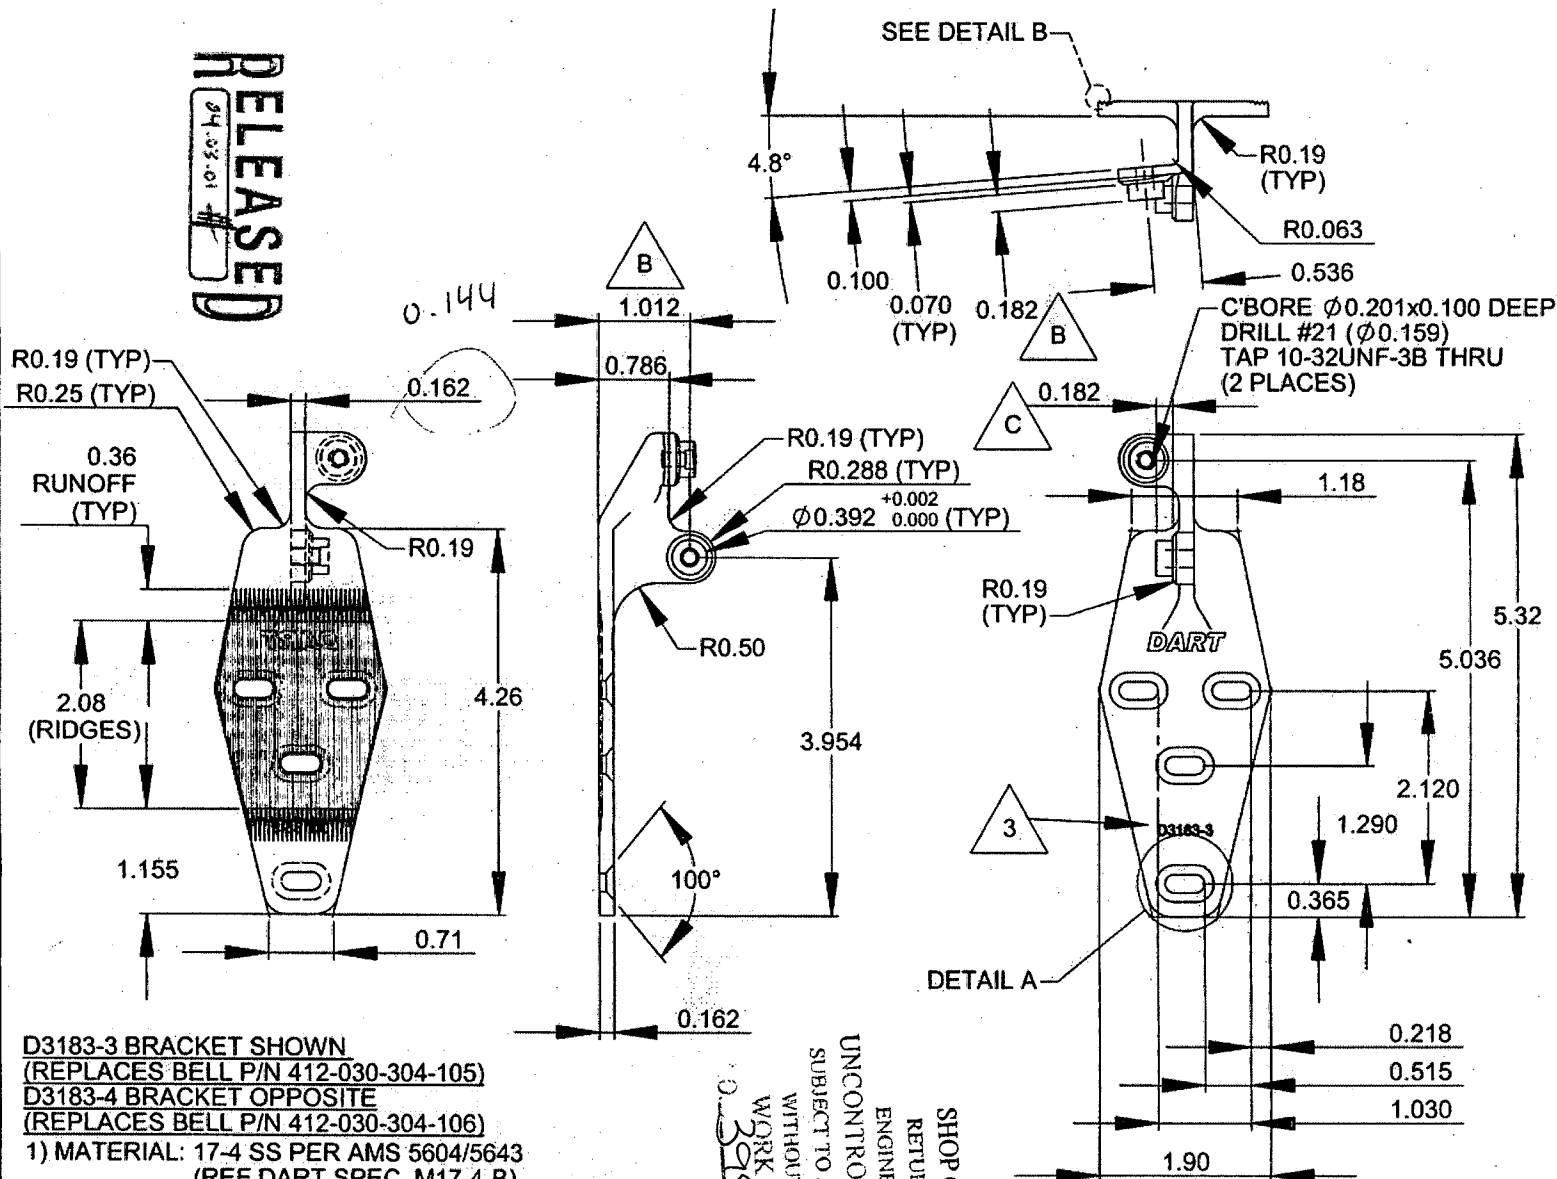

D3183-3 BRACKET SHOWN  
(REPLACES BELL P/N 412-030-304-105)  
D3183-4 BRACKET OPPOSITE  
(REPLACES BELL P/N 412-030-304-106)

- 1) MATERIAL: 17-4 SS PER AMS 5604/5643  
(REF DART SPEC. M17-4-B)  
MIN ULTIMATE STRENGTH = 150 ksi  
MIN YIELD STRENGTH = 100 ksi
- 2) BREAK ALL SHARP EDGES 0.005 TO 0.015
- 3) ENGRAVE DART P/N & LOGO AS SHOWN
- 4) TOLERANCES ARE PER DART QSI 018 UNLESS OTHERWISE NOTED
- 5) ALL DIMENSIONS ARE IN INCHES

SHOP COPY  
RETURN TO  
ENGINEERING  
UNCONTROLLED COPY  
SUBJECT TO AMENDMENT  
WITHOUT NOTICE  
WORK ORDER  
039924


COPYRIGHT © 2003 BY DART AEROSPACE LTD.

THIS DOCUMENT IS PRIVATE AND CONFIDENTIAL AND IS SUPPLIED ON THE EXPRESS CONDITION THAT IT IS NOT TO BE USED FOR ANY PURPOSE OR COPIED OR COMMUNICATED TO ANY OTHER PERSON WITHOUT WRITTEN PERMISSION FROM DART AEROSPACE LTD.

RELEASED  
04-03-01




DESIGN #	DRAWN BY UP	<b>DART AEROSPACE LTD</b> HAWKESBURY, ONTARIO, CANADA	
CHECKED #	APPROVED #	DRAWING NO. <b>D3183</b>	REV. C SHEET 4 OF 4
DATE <b>04.02.17</b>		TITLE <b>BRACKET ASSEMBLY</b>	SCALE 1:1

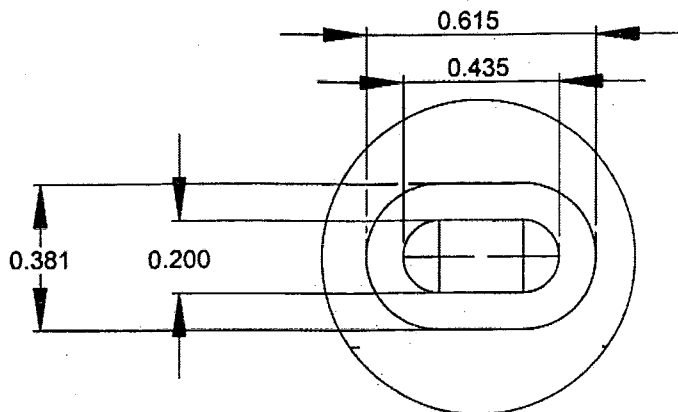


DETAIL A (2 : 1)

**RELEASED**  
04.03.01 #

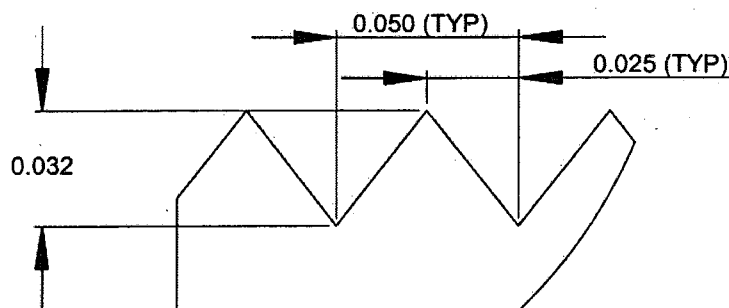

DETAIL B (20 : 1)

SHOP COPY  
RETURN TO  
ENGINEERING  
UNCONTROLLED COPY  
SUBJECT TO AMENDMENT  
WITHOUT NOTICE  
WORK ORDER  
NO. 399124

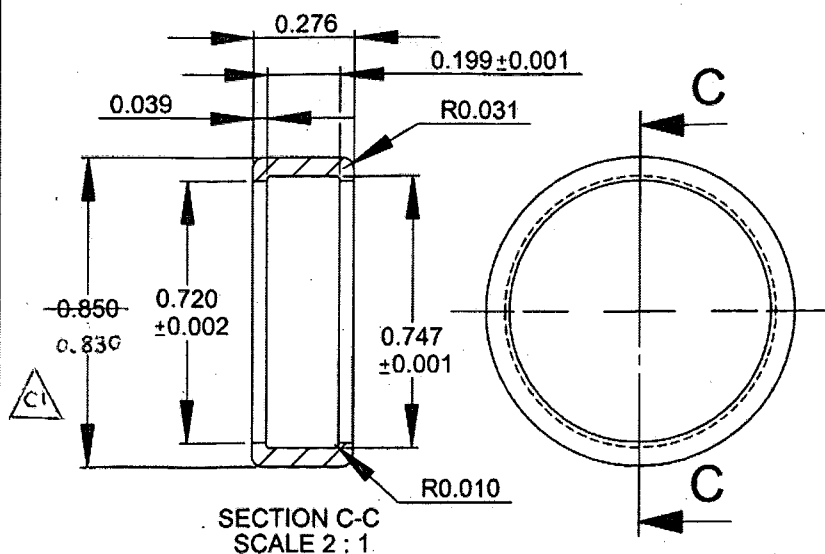

**D3183-9 CAP**

- 1) MATERIAL: DELRIN ROD, Ø1.00  
(REF DART SPEC. M-DELRIN-R1.00)
- 2) TOLERANCES ARE PER DART QSI 018  
UNLESS OTHERWISE NOTED
- 3) ALL DIMENSIONS ARE IN INCHES

**D3183-045 BEARING ASSEMBLY**

- 1) ASSEMBLE D3183-5 BEARING AND  
D3183-9 CAP

**COPYRIGHT © 2003 BY DART AEROSPACE LTD.**

THIS DOCUMENT IS PRIVATE AND CONFIDENTIAL AND IS SUPPLIED ON THE EXPRESS CONDITION THAT IT IS NOT TO BE USED FOR ANY PURPOSE OR COPIED OR COMMUNICATED TO ANY OTHER PERSON WITHOUT WRITTEN PERMISSION FROM DART AEROSPACE LTD.



## Chris Provencal

---

**From:** David Shepherd [dshepherd@dartaero.com]  
**Sent:** July 17, 2008 11:29 AM  
**To:** 'Chris Provencal'  
**Subject:** RE: Emailing: NCR\_D3183-3.jpg

Chris,

I believe this is an acceptable deviation.  
The critical thing is that the base thickness (ie. the face that mates with sliding door) is within spec.

David

-----Original Message-----

From: Chris Provencal [mailto:cprovencal@dartaero.com]  
To: 'David Shepherd'  
Subject: Emailing: NCR\_D3183-3.jpg

David,

Qty(5) D3183-3 Brackets, the 0.162 thickness of the roller flange is up to 0.142 min on some parts. The thickness isn't uniform, there are several operations that make this flange, at least one of them must have had a wrong offset. I'm assuming that these rollers are critical to holding the door on in flight and I have no SR to justify the thickness reduction, so I would scrap them.

What is your opinion?

-Chris